

AS BUILT
 1310 W. STEWART DR. #307
 ORANGE, CALIFORNIA




SPECTRUM
 SPACE DESIGN

101 S. KRAEMER BLVD #100
 PLACENTIA, CA 92870
 714.496.4185 • FAX. 223.0663

3-31-10

1,712 SF

JOB 10-025

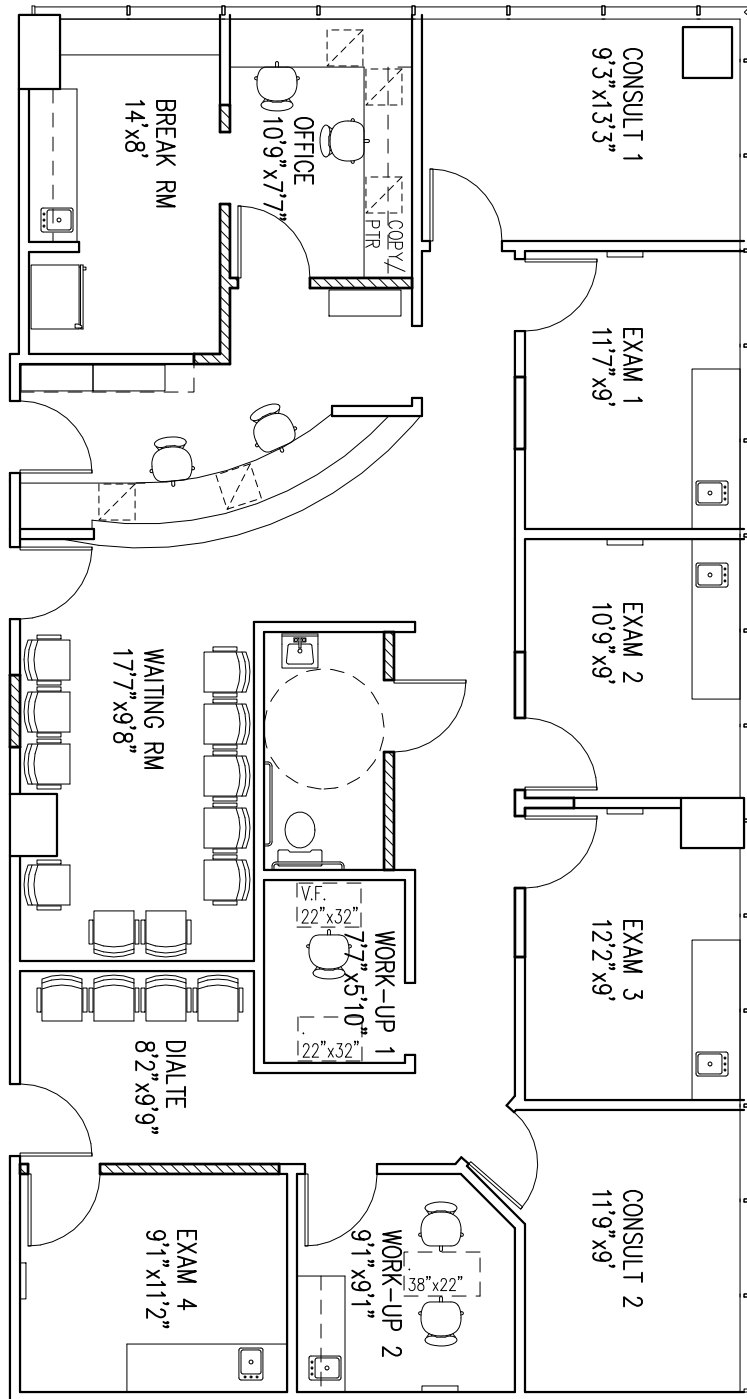

DR. TRAN
 1310 W. STEWART DR. #307
 ORANGE, CALIFORNIA



SPECTRUM
 SPACE DESIGN
 101 S. KRAEMER BLVD #100
 PLACENTIA, CA 92870
 714.496.4185 • FAX.223.0663

4-5-10
SF
JOB 10-025